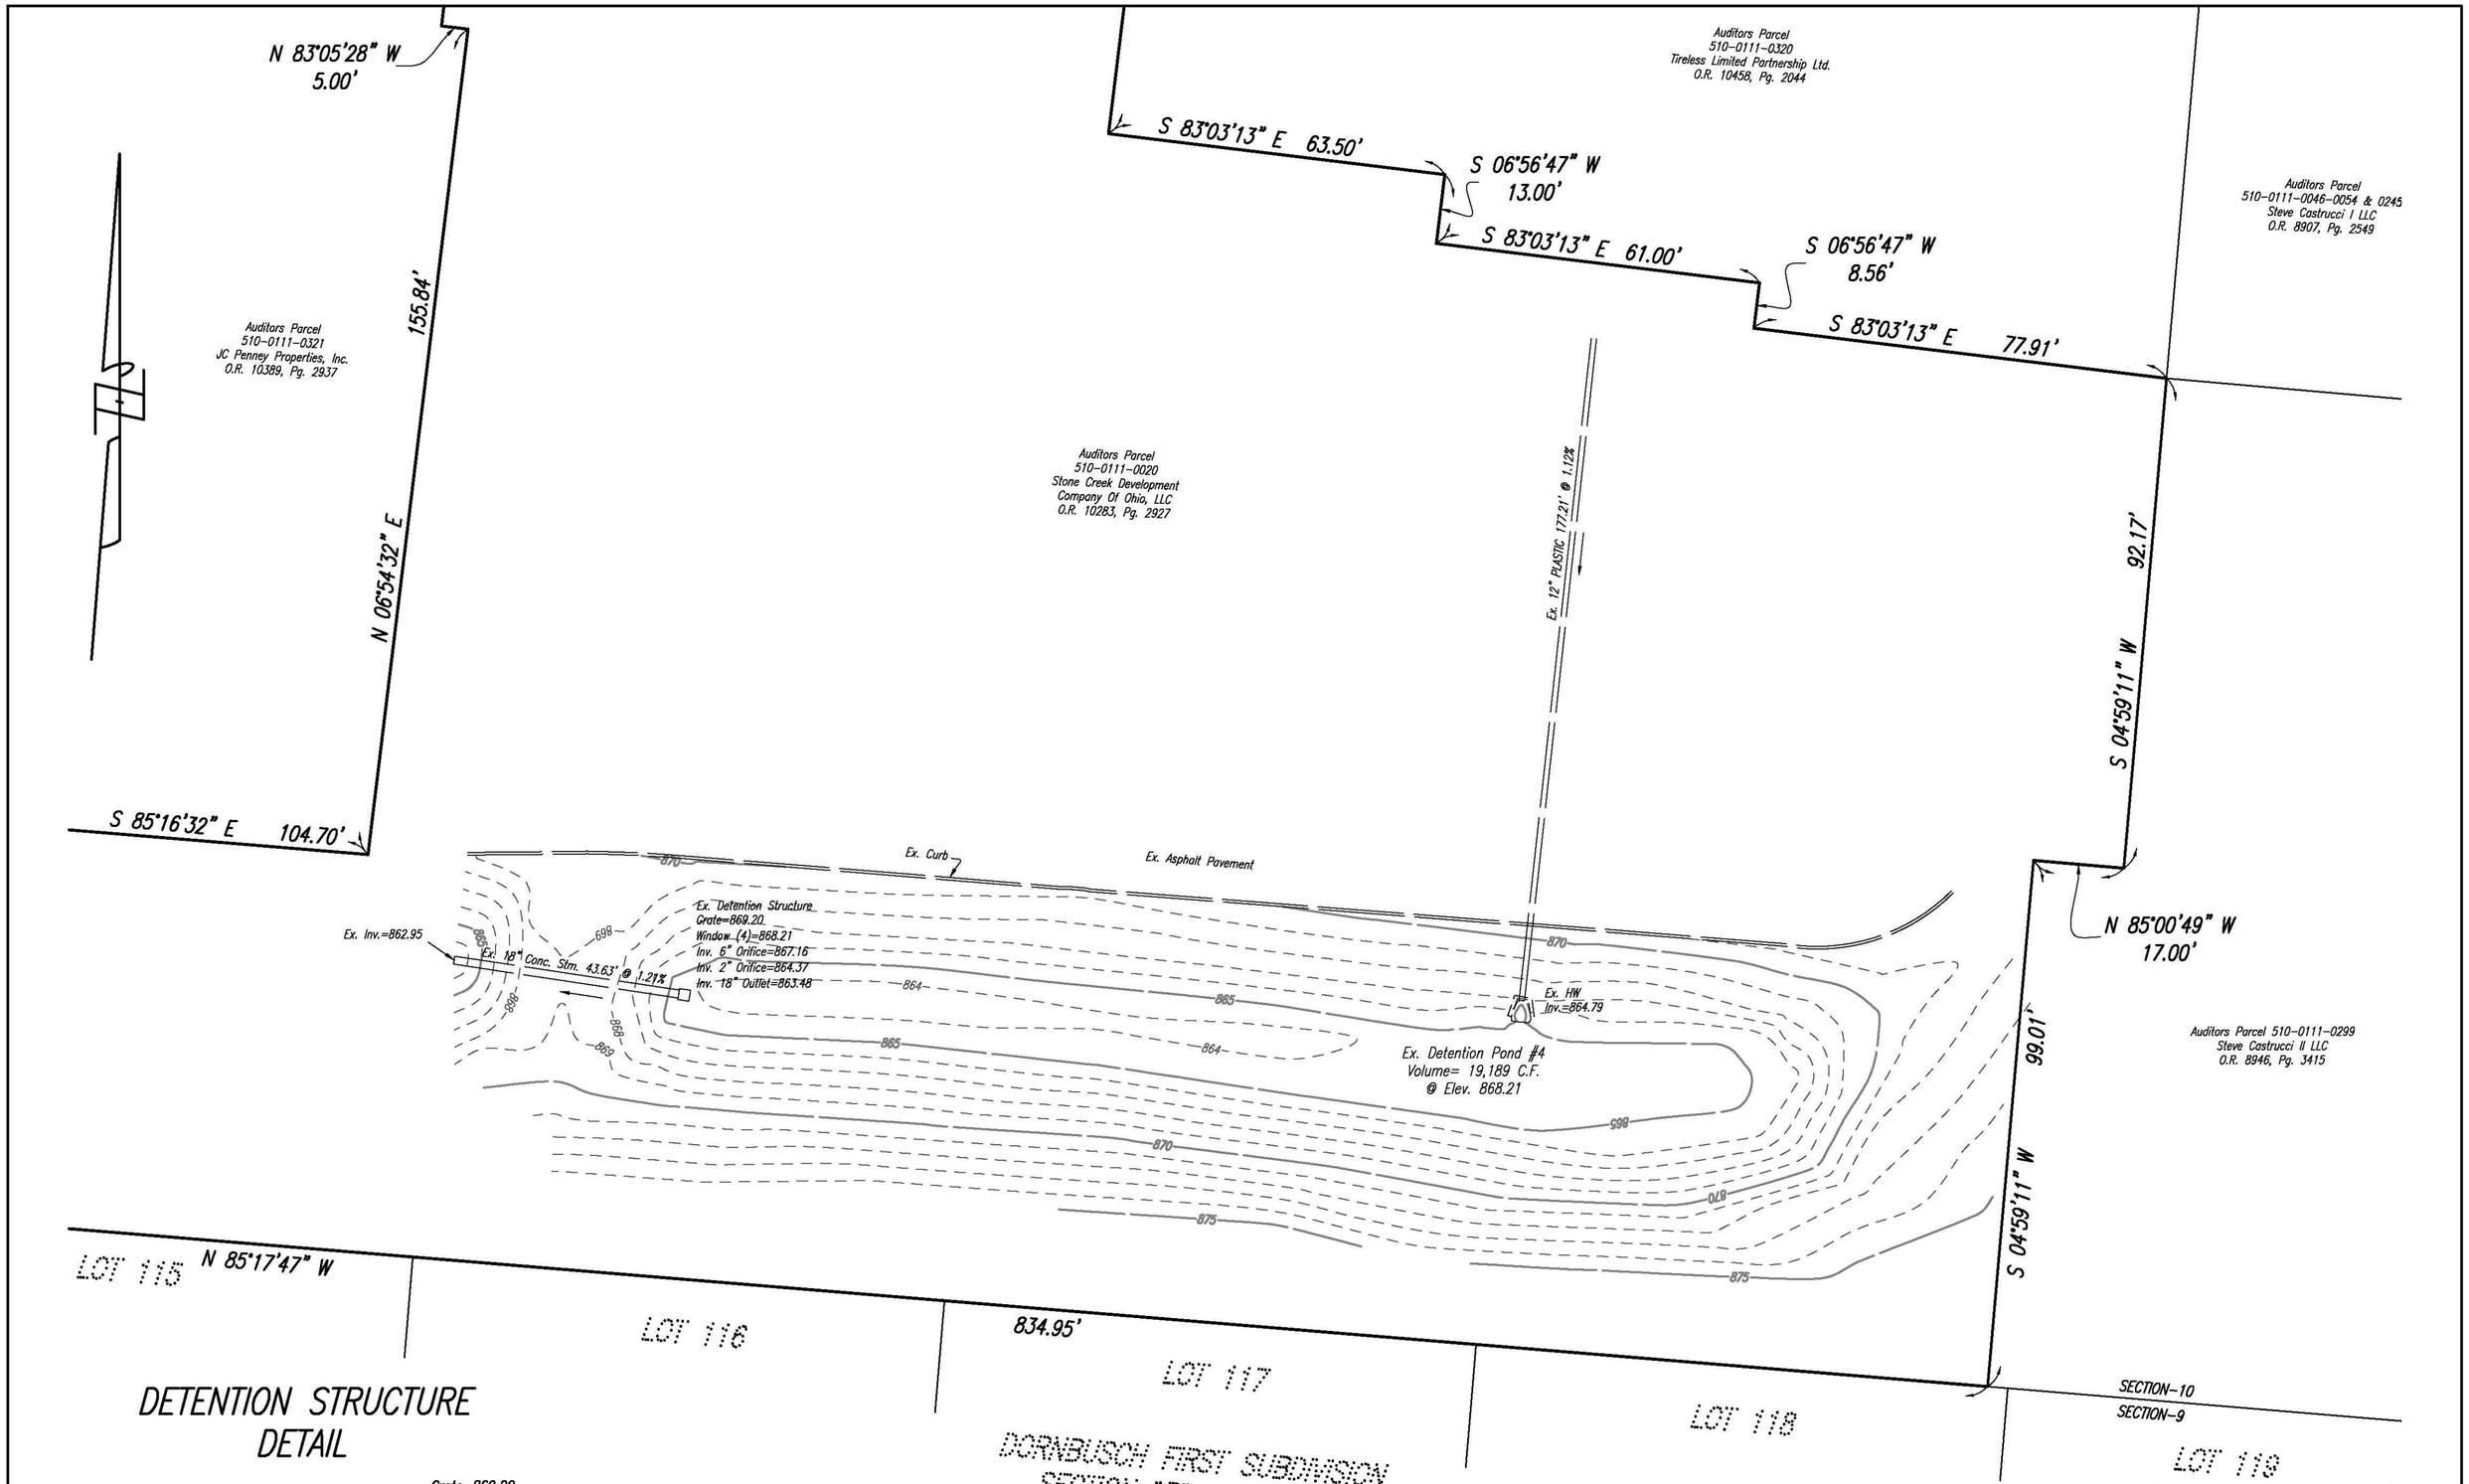

DETENTION STRUCTURE DETAIL

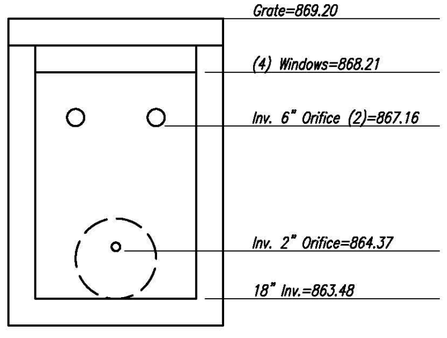

ACTUAL RELEASE RATES:

Q1 = 0.21 cfs
Q10 = 1.93 cfs

GRAPHIC SCALE

20 0 10 20 40 80

(IN FEET)
1 inch = 20 ft.

STONE CREEK TOWNE CENTER DETENTION POND #4 AS-BUILT

SECTION-16, TOWN-2, E.RANGE-1
MIAMI PURCHASE, COLERAIN TOWNSHIP
HAMILTON COUNTY, OHIO

REVISIONS

DWG.:

SCALE	DATE	JOB.NO.	DRAWN	
1"=30'	7-12-07			1/1